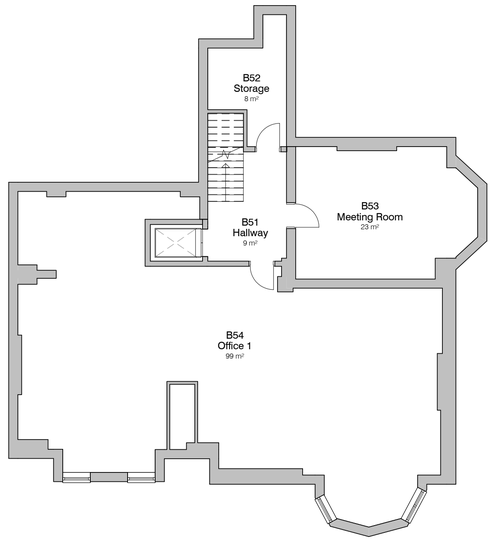

1 Level B1 - GA Proposed
1 : 100

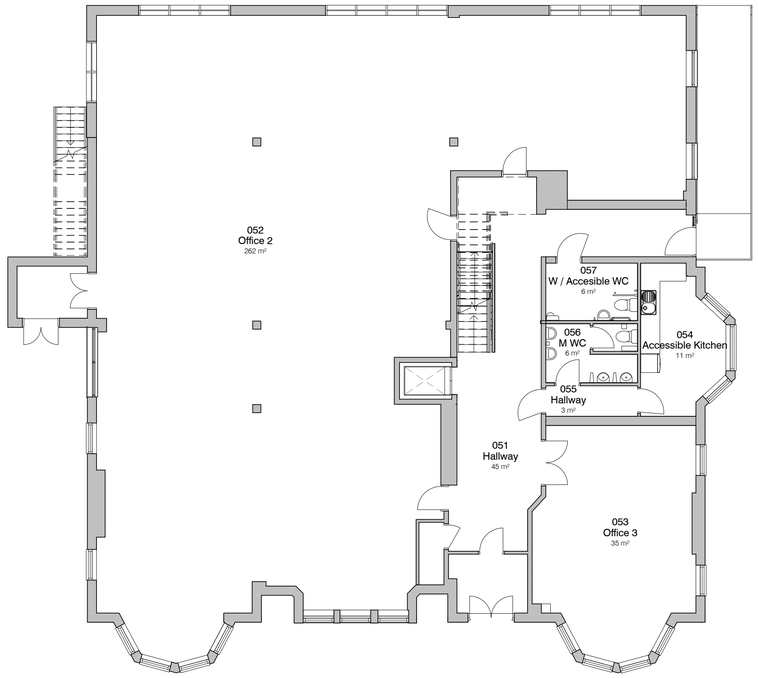

2 Level 0 - GA Proposed
1 : 100

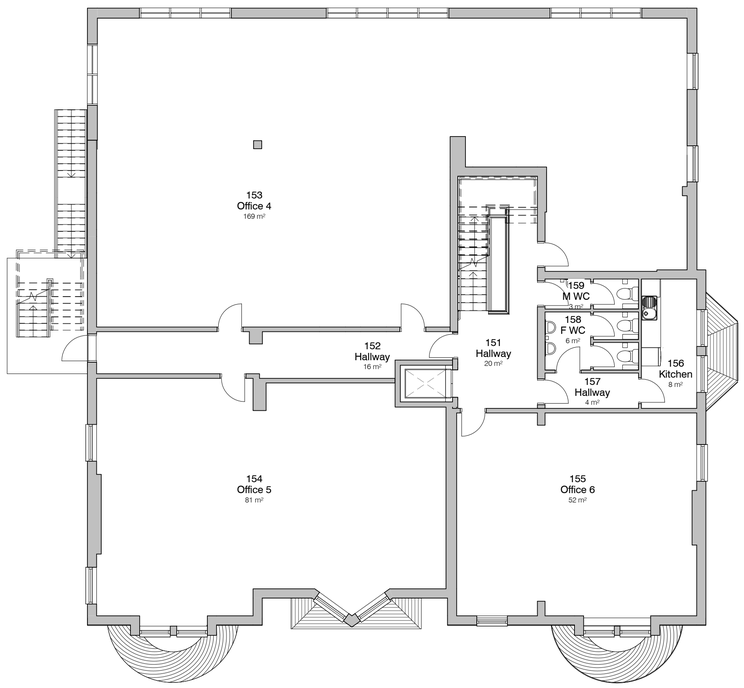

3 Level 1 - GA Proposed
1 : 100

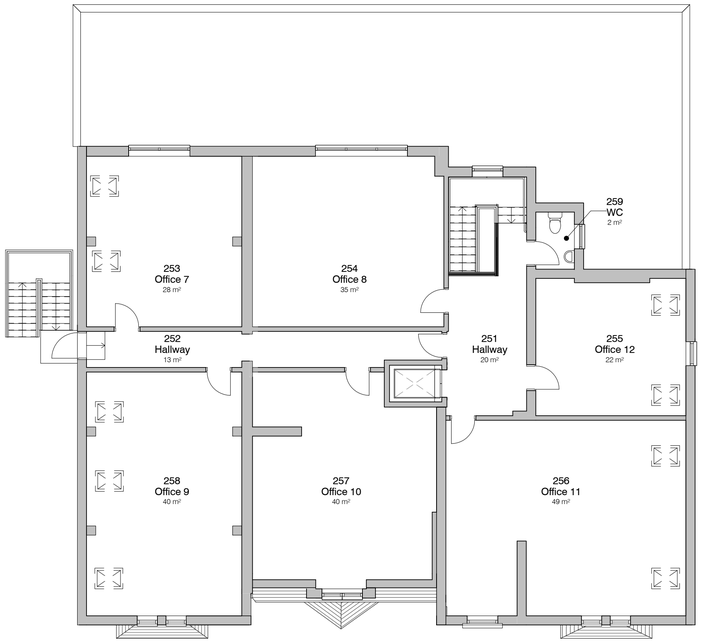

4 Level 2 - GA Proposed
1 : 100

1 0 1 2 3 4 5
SCALE 1:100 m

D	Plans as-built	20/04/21	JK
C	Amendments as per Contractors Requests	21/05/19	JK
B	Lift Shaft Dimensions	17/05/19	JK
A	Amendments as per Contractors Requests	09/05/19	JK
6	Plans to SE Design	20/02/19	JK
5	Rear demolition	23/11/18	JK
4	Internal Layout	21/11/18	FY
3	PLANNING	08/10/18	SG
2	PLANNING	12/06/18	SG
1	Rear Extension	19/03/18	SG

DEBTAL ARCHITECTURE

72 Bury New Road, Manchester, M25 0JU.
Tel: 0161 773 1630
office@debtalarchitecture.co.uk www.debtalarchitecture.co.uk

CLIENT
Urban and Rural

PROJECT
89 Middleton Rd - The Belmont

TITLE
Proposed GA Plans

PROJECT NO. DRAWING NO. REV.
DA17087.2. 003. D

STATUS
As Built

SCALE @ A1 DATE DRAWN BY
1 : 100 23 NOV 2018 JK

© COPYRIGHT - ALL RIGHTS RESERVED THIS DRAWING MUST NOT BE REPRODUCED WITHOUT PERMISSION. ALL DIMENSIONS RELATIVE TO THIS DRAWING TO BE CHECKED ON SITE. DESIGNER TO BE NOTIFIED OF ANY DISCREPANCIES BEFORE WORK IS PUT IN HAND. THIS DRAWING IS TO BE READ IN CONJUNCTION WITH ALL OTHER DRAWINGS AND MUST BE CHECKED AGAINST ANY OTHER STRUCTURAL DRAWINGS PROVIDED. THIS DRAWING MUST NOT BE USED FOR CONSTRUCTION UNLESS ISSUED FOR CONSTRUCTION. ALL DIMENSIONS ARE IN MILLIMETRES UNLESS OTHERWISE STATED.